SONY

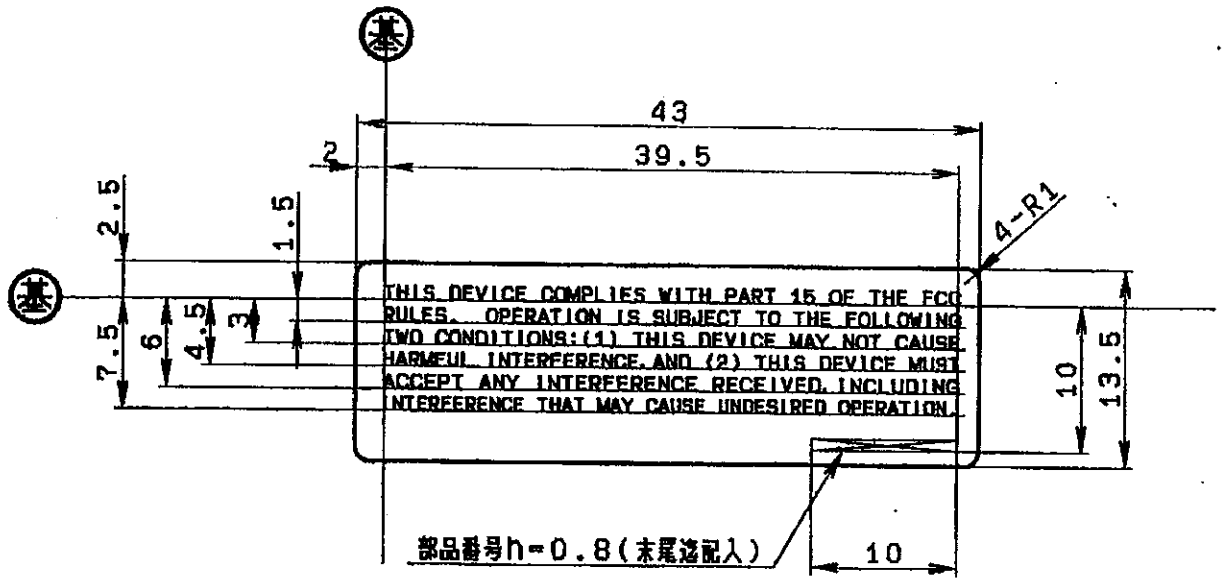

材料構成図 A

材質：PETP+AL+PSA

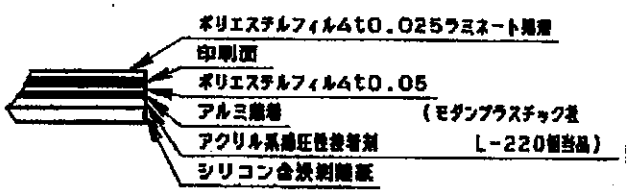

MATERIAL CONSTRUCTION

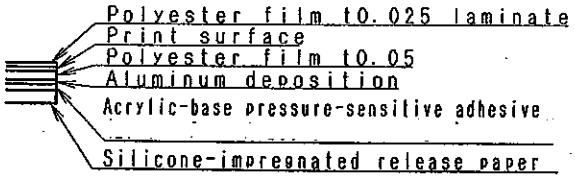

品質特性： ソニー部品設計基準 機能板の 第7－1項に定める各特性を満足すること。
使用注意事項：耐薬品特性の試験は製品に貼付した状態にて行なわれるので貼付条件には充分留意すること。(ソニー部品設計基準 機能板 第7－1－4項)

注） 1．版下校正は必ず受けること
2．文字 書体 ：HELVETICA
字高 ： 1

1987 3.21

末尾-01 印刷色：地－黒，文字－マヰ(銀)
△2 末尾-11 印刷色：地－白，文字－黒

	末尾	材料構成	
	-01	A	
△2	-11	B	
△3	-21	A	接着剤、粗面用Rタイプ相当

HISTORY X COUNT	SUFFIX REPL.		ECN-NO. DATE	REVISION	SIGN.
△3x			-		
△3x			-		
△4x			-		
△5x 1	-21	φ	MC-710024 '97.3.5	接着剤 Rタイプ追加	村田
△6x 6	-01 -11	φ	EV-260113 '92.4.17	末尾-11 追加	山塚
△7x			EV-103928 '91.12.19	P/N RELEASE M.M	

AMF
AMF

UNIT	mm
ANGLE	
SCALE	2:1
TOLERANCE STS-2	
~~L≤4~~	~~±0.1~~
4<L≤16	±0.2
16<L≤63	±0.3
63<L≤250	±0.4
250<L	±0.6
USED ON	
RANK	
FAMILY	MLA
ORIGINAL MODEL	GDX-970(UC2)
MATERIAL(COLOR)	△2上記 ~~PETP+AL+PSA~~
FINISH(COLOR)	凸版印刷後 △2末尾-01のみ PETP t0.025 ラミネート処理
DESCRIPTION (1)	
(2)	FCCラベル
PART NO.	3-947-781-~~01~~ △2上記
SHEET	1/1

DRAWN BY	PLANNED BY	CHECKED BY	APPROVED BY
PV1-2 '91.12.5 中野	PV1-2 '91.12.5 大森	PV1-2 '91.12.5 高橋	PV1-2 '91.12.5 木村

TENTATIVE
MODEL
PART NO. 0-795-782-01

THIS DOCUMENT IS THE PROPRIETARY PROPERTY OF SONY. ITS USE IS AUTHORIZED ONLY FOR RESPONDING TO A REQUEST FOR QUOTATION, OR FOR THE PERFORMANCE OF WORK FOR SONY. ALL QUESTIONS MUST BE REFERRED TO THE LOCAL PURCHASING DEPARTMENT OF SONY.

A4

ISSUED '91.12.5

V(ST GDX970 0-795-782 FCCラベル 91/12/10 14:45:46

DRAWING (TYPE B42)
SONY STANDARD '90.10